

**GENERAL NOTES:**

1. THIS DRAWING IS TO BE READ IN CONJUNCTION WITH DRAWINGS ISSUED BY CONSULTANTS OF VARIOUS DISCIPLINES, IN PARTICULAR STRUCTURAL, ELECTRICAL, MECHANICAL AND SERVICES ENGINEERS.
2. ANY DISCREPANCIES BETWEEN DRAWING LAYOUTS ARE TO BE BROUGHT TO THE ATTENTION OF THE ARCHITECTS PRIOR TO ANY WORK BEING PUT IN HAND.
3. FIGURED DIMENSIONS ARE TO BE TAKEN IN PREFERENCE TO SCALED MEASUREMENTS AND LARGE SCALE DETAIL DRAWINGS WILL SUPERSEDE SMALL SCALE GENERAL LAYOUT DRAWINGS.
4. CONTRACTOR AND SUBCONTRACTORS TO CHECK ALL DIMENSIONS AND LEVELS ON SITE PRIOR TO ANY WORK BEING PUT IN HAND.
5. ALL WORK ON SITE IS TO CONFORM TO GOOD BUILDING PRACTICE AND ALL RELEVANT NATIONAL BUILDING CODES AND STANDARDS.

| REVISIONS |          |                                                                                                                            |       |
|-----------|----------|----------------------------------------------------------------------------------------------------------------------------|-------|
| No        | Date     | Description                                                                                                                | Drawn |
| 0         | 25/05/22 | Door Schedules and Floor plans issued to Ironmongery specialist.                                                           | KM    |
| 0         | 25/06/23 | Issued For Construction - Contract Signing Pack                                                                            | KM    |
| 1         | 25/07/11 | Issued for Construction                                                                                                    | KM    |
| 2         | 25/07/28 | Drywall changed to Hebel, issued for construction.                                                                         | KM    |
| 3         | 25/08/14 | Revised duct exhaust positions and new walls to cover space. Beam closure detail with the facade treatment and engagement. | KM    |
| 4         | 25/09/19 | Updated floor plans issued. Adjustments made to DBs, strengthening indicated, tops added where missing.                    | KM    |

[illegible]

|                      |                    |  |
|----------------------|--------------------|--|
| FOR INFORMATION      | DESIGN DEVELOPMENT |  |
| SKETCH PLAN          | TENDER             |  |
| SDP                  | CONSTRUCTION       |  |
| MUNICIPAL SUBMISSION | AS BUILT           |  |

**FOR CONSTRUCTION**

|                                  |           |
|----------------------------------|-----------|
| Consultants                      | Signature |
| Client<br>WITS HEALTH CONSORTIUM |           |
| Architect<br>Designer            |           |

**tc  
rpv**  
ARCHITECTS

**TCRPV ARCHITECTS**  
129 Patricia Road  
Atholl Towers  
Sandton  
Johannesburg

Tel +27 11 784 3860



[www.tcrpv.co.za](http://www.tcrpv.co.za)

WITS BIOHUB


CLIENT: WITS HEALTH CONSORTIUM

PROJECT ADDRESS  
36 Boundary Road, Isle of Houghton Office Park,

|                                  |              |                       |       |                       |       |
|----------------------------------|--------------|-----------------------|-------|-----------------------|-------|
| REM of ERF 2477, Houghton Estate |              |                       |       |                       |       |
| SIZE                             | SCALE        | CURRENT REVISION DATE | DRAWN | TCRPP/ Project Number | Stage |
| A0                               | As indicated | 25/09/19              | LV    | 4419                  | C     |

Floor Plans- OT3-TF

|                               |            |      |       |      |      |            |     |
|-------------------------------|------------|------|-------|------|------|------------|-----|
| Project Code                  | Originator | Zone | Level | Type | Role | Dwg Number | REV |
| WHCL-TCR- ZZ-L3 -DR-AR-LP1004 |            |      |       |      |      |            | 4   |

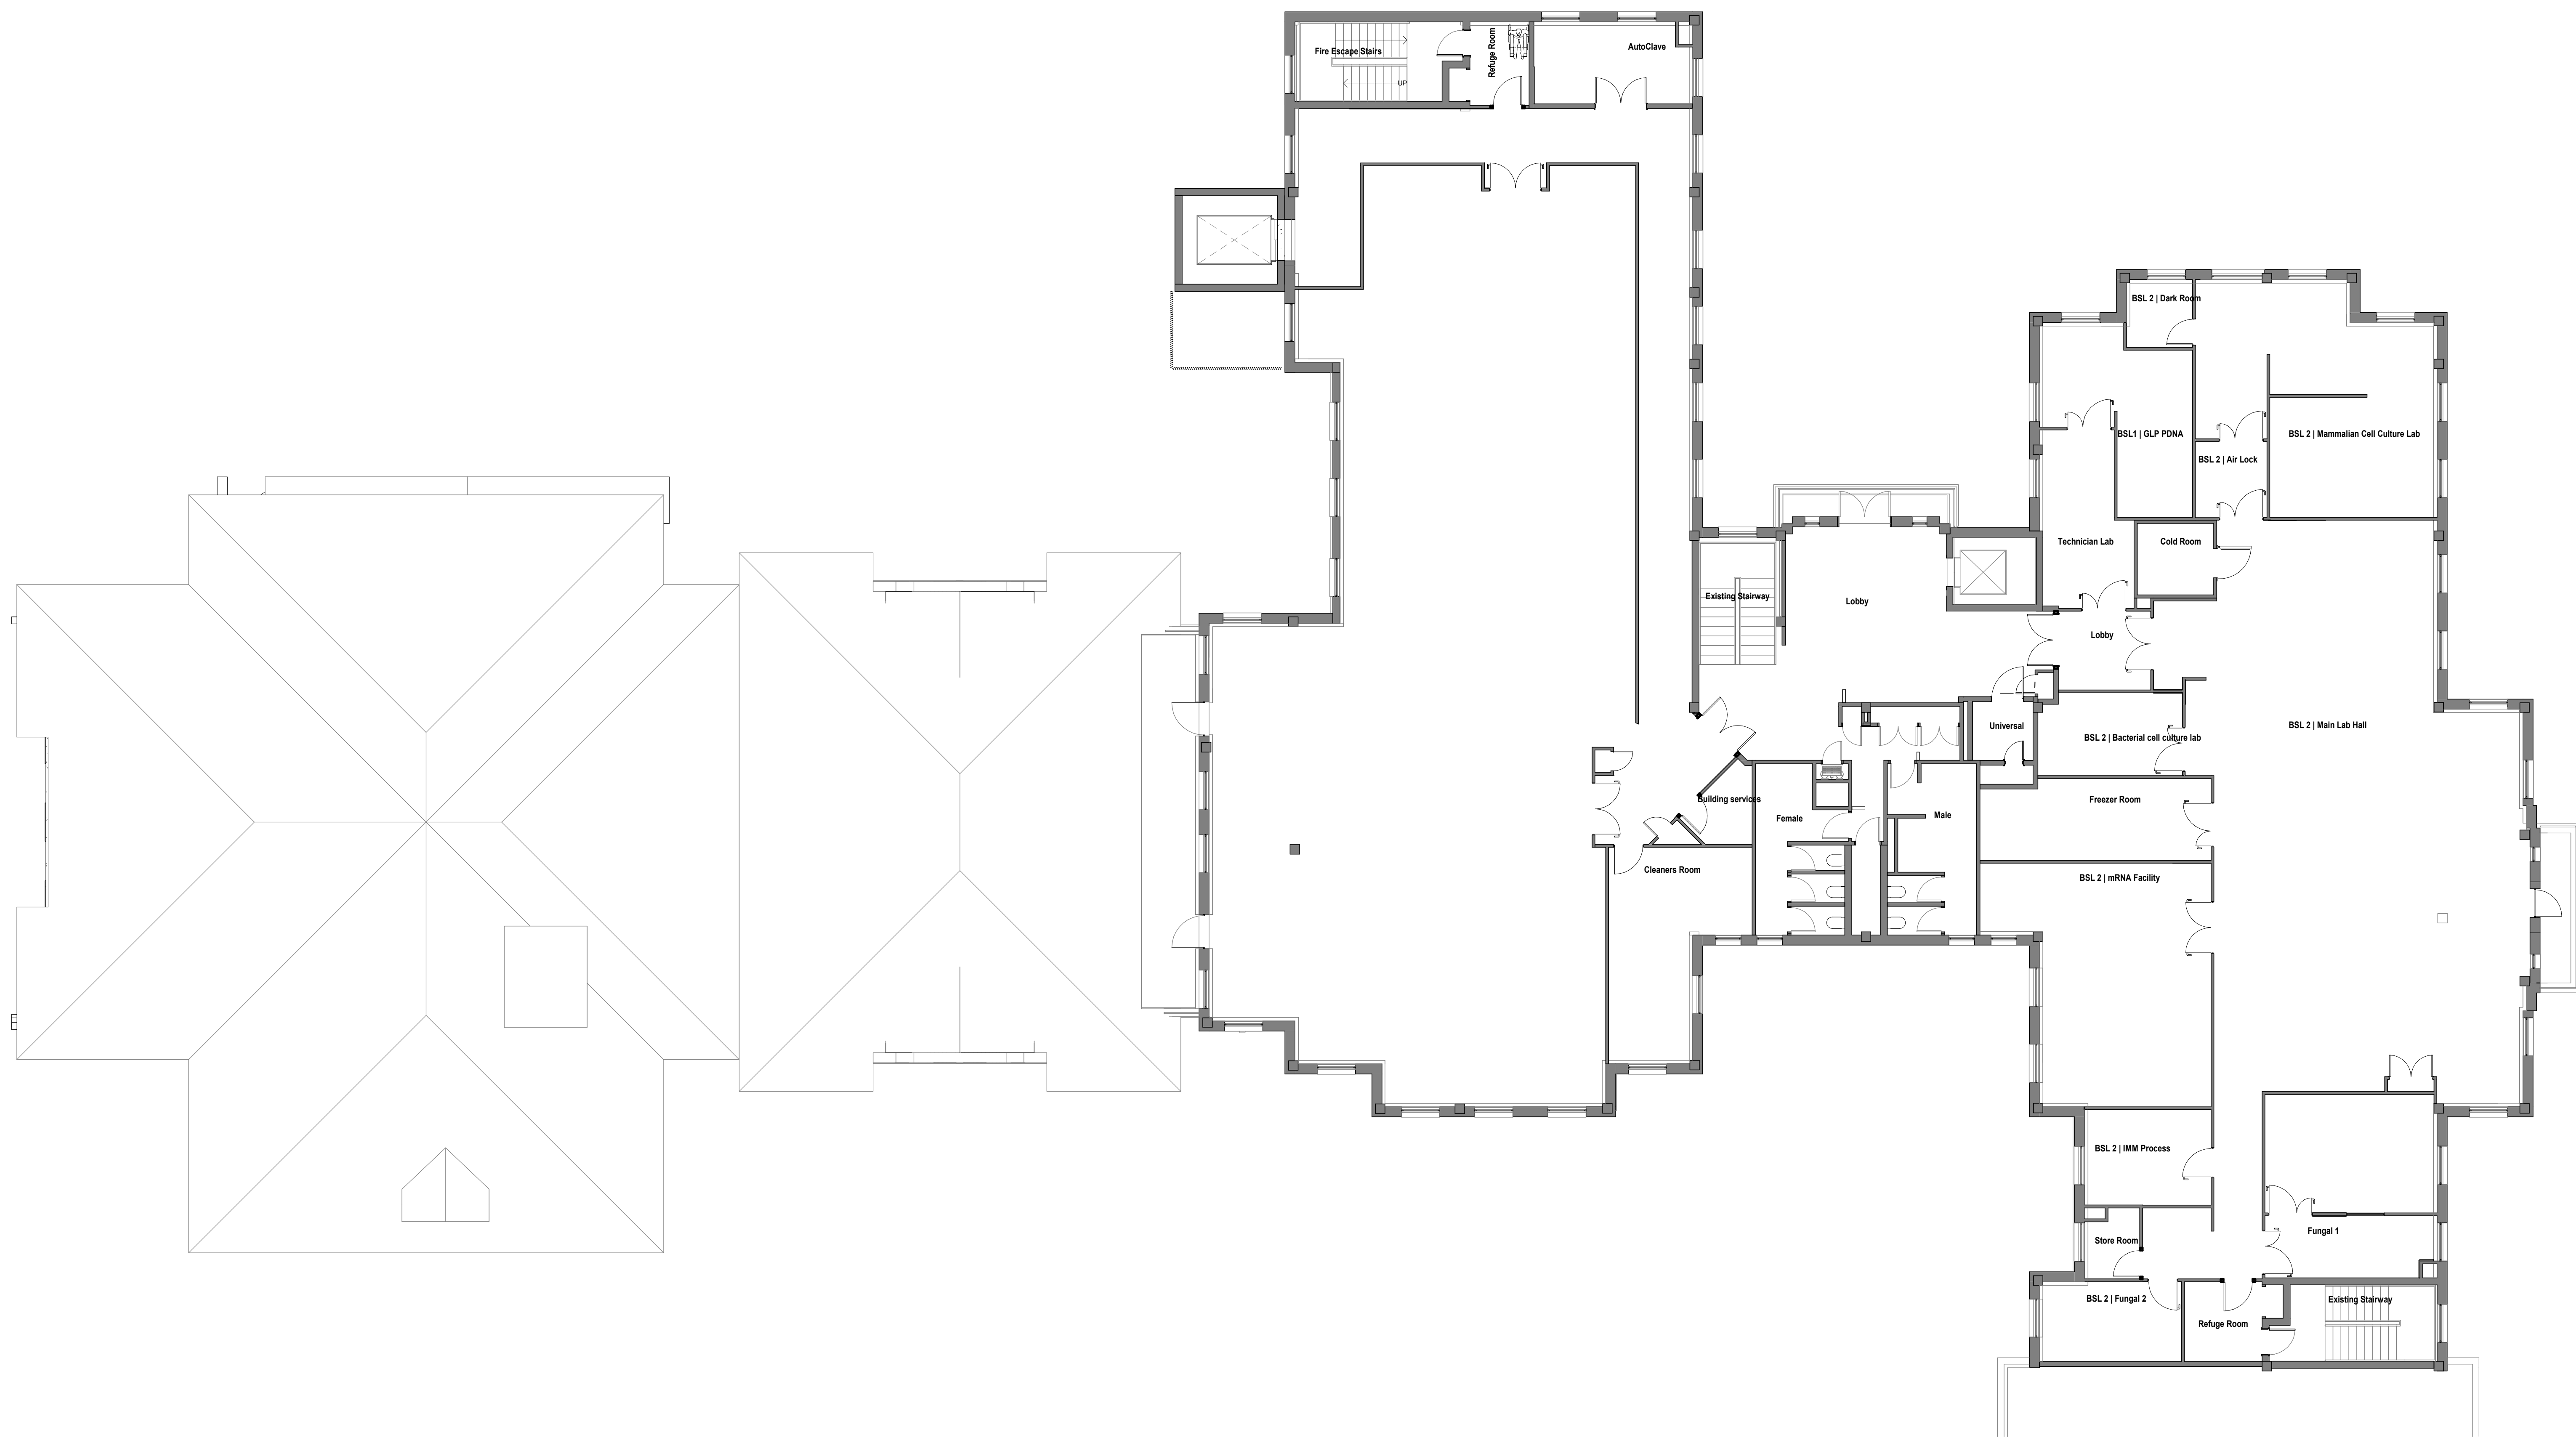

## Floor Plans- OT3 – TF

Scale 1 : 100

